

As Built Layout Drawings Unit 6 Lismirrane Industrial Park 1630mm

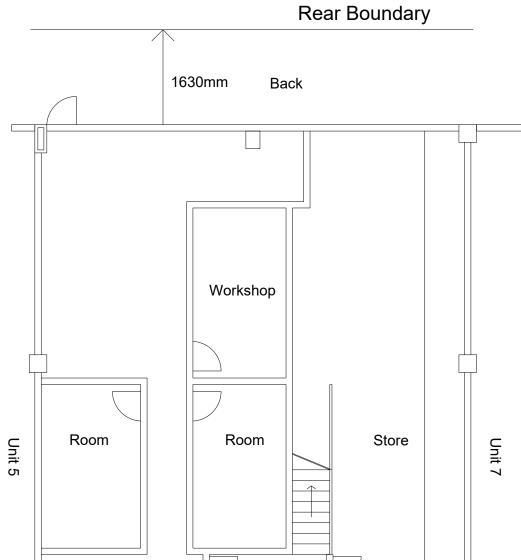

Distance from rear Front wall of unit to **Ground Floor** gate 1860mm

WC

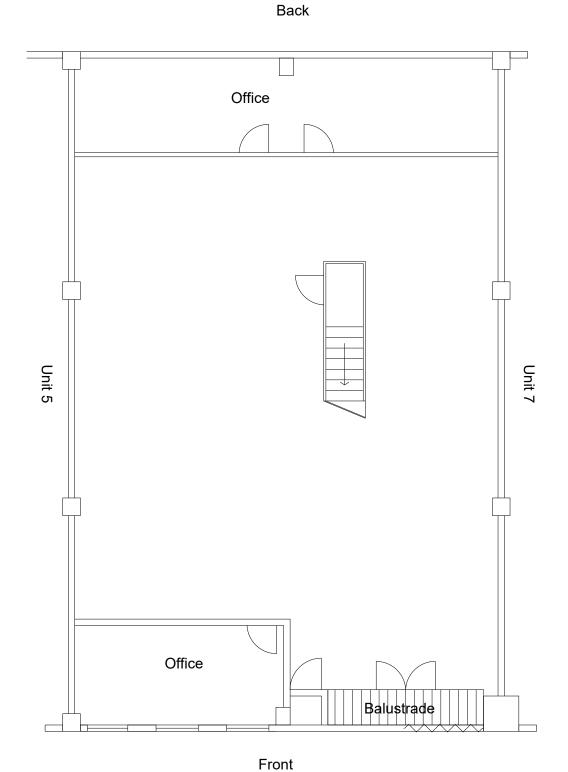

First Floor

©Copyright reserved Revision Notes Scale Bar Client Site Address Unit6, Lismarrine industrial Park, Elstree Road Borehamwood WD6 3EE Unit 6 Lismirrane Industrial Park Drawing Title As Built Layout Drawings CHARTERED BUILDING SURVEYORS Drawings prepared for: Planning and Development-Boundary Issues





Expert Witness-Party Walls-Insurance
Project Management Conservation-Dilapidations
Subsidence and Settlement

Link House, 49 Theobald Street

Tel: 0208 207 6100 www.simonlevy.zel

Drawing Number: SLA 0000 000

Date: 23.09.2025 Scale: 1:11 Drawn by: SD DWG Size:

Registered Office: Link House, 49 Theobald Steet

Established in 1988.